



CITY OF COLWOOD

3300 Wishart Road | Colwood | BC V9C 1R1 | 250 294-8153
planning@colwood.ca | www.colwood.ca

File: DPA00002

DEVELOPMENT PERMIT AMENDMENT DPA00002

THIS PERMIT, issued **DECEMBER 20, 2023** is,

ISSUED BY: **CITY OF COLWOOD**, a municipality incorporated under the *Local Government Act*,
3300 Wishart Road, Victoria, BC, V9C 1R1

(the "City")

PURSUANT TO: Section 490 of the *Local Government Act*, RSBC 2015, Chapter 1

ISSUED TO: **COLWOOD (LATORIA BLVD) NOMINEE LTD., INC. BC1194838**
200-8809 Heather Street
Vancouver, BC V6P 3T1

(the "Permittee")

-
1. This Form and Character Development Permit applies to those lands within the City of Colwood described below, and any and all buildings, structures, and other development thereon:

Lot 2, Sections 39 and 40, Esquimalt Land District, Plan EPP65598
3554 Ryder Hesjedal Way

(the "Lands")

2. This Development Permit regulates the development of the Land, and supplements the "*Colwood Land Use Bylaw, 1989*" (Bylaw No. 151), and amends Development Permit No. DP-20-012 to ensure the form and character considerations for the construction of a garbage enclosure and associated site improvements, are consistent with the guidelines for areas designated as "Centres" in the City of Colwood Official Community Plan (Bylaw No. 1700).
3. This Development Permit is **NOT** a Building Permit or a subdivision approval.
4. This Development Permit is issued subject to compliance with all of the bylaws of the City of Colwood that apply to the development of the Lands, except as specifically varied by Council or supplemented by this Permit
5. The Director of Development Services or their delegate may approve minor variations to the plans and specifications attached to and forming part of this Development Permit, provided that such minor variations are consistent with the overall intent of the original plans and do not alter the

form and character of the development authorized by those plans.

6. If the Permittee does not substantially start the construction permitted by this Permit within 24 months of the date of this Permit, the Permit shall lapse and be of no further force and effect.
7. All conditions of Development Permit DP-20-012 will also apply.
8. The development is to be constructed in accordance with the following plans and specifications, which are attached to and form part of this permit:
 - Schedule 1 Site Plan and Architectural Drawings prepared by MCM Architects, dated October 6th, 2023.
 - Schedule 2 Landscape and Lighting Plan prepared by LADR Landscape Architects, dated October 5th, 2023.
 - Schedule 3 Post-construction Landscaping additions prepared by LADR Landscape Architects, dated December 11th, 2023.
9. This Development Permit amends Development Permit No. DP-20-012 and authorizes the construction of a garbage enclosure and associated site improvements. The Lands shall not be altered, nor any buildings or structures constructed, except in accordance with the following conditions:

FORM AND CHARACTER

General

- 9.1 This Development is to be constructed in accordance with the Site Plan and Architectural Drawings prepared by MCM Architects dated October 6th, 2023 (Schedule 1).

Landscaping

- 9.2 The design and construction of the proposed landscaping shall be in substantial compliance with the Landscape drawing set prepared by LADR Landscape Architects dated October 5th, 2023 (Schedule 2) and the post-construction landscaping additions dated December 11th, 2023 (Schedule 3).
- 9.3 The landscape security deposit collected under DP-20-012, in the amount of **\$179,300.00**, shall be returned upon receipt of a signed statement of substantial completion from a landscape architect to the satisfaction of the Director of Engineering & Development Services.

ISSUED ON THIS 20 DAY OF DECEMBER 2023.



John Rosenberg, ASCT
Director of Engineering & Development Services

DATA INFORMATION TABLE

RESIDENCE AT LATORIA- COLWOOD - Site Statistics	
Civic address	3554 Ryder Hesjedal Way, Colwood, British Columbia
Legal Description	LOT 2 SECTIONS 39 & 40 ESQUIMALT DISTRICT PLAN EPP65598
PID	030-310-521
Zone	CD31

Lot Area		
	Permitted minimum lot area- apartment lots	Proposed/ existing lot area
Hectare	0.7	0.727
Square meters	7,000	7,270
Square feet	75,347	78,253.60

Gross Floor Area		
	SF	SM
Gross floor area - Building A		
Ground	12,430	1,154.78
2	12,380	1,150.14
3	12,380	1,150.14
4	12,380	1,150.14
5	12,350	1,147.35
Mechanical Penthouse	200	18.58
Total- Building A	62,120	5,771.14

Commercial (Retail) Floor Space (SM)		
	GFA - SF	GFA - SM
Principal Building	N/A	
Total	1,755	163.04

Floor Area Ratio	
Maximum Permitted FAR	Proposed FAR
1.4	5771.14 SM / 7270 SM = 0.79

Development Density	
Maximum Permitted	Proposed
105 units per hectare for apartment housing	72 Units
105 x 0.727 = 76.33 = 76 units	

Coverage	
Maximum Permitted Coverage	Proposed Coverage
30%	1148.75 SM / 7270 SM (LOT AREA) = 16%

Setbacks- Principal Building		
	Minimum Setback Required	Setback Proposed
Front Yard -Latoria	6 M	6.2 M
Rear Yard	6 M	49.9 M
Side Yard- Exterior-RHW	6 M	6.9 M
Side Yard	13 M	13.7 M

Number of Principal Building Storeys		
	Maximum Permitted Number of Storeys	Proposed Number of Storeys
Principal Building	N/A	5

Building Heights		
	Maximum Permitted Height	Proposed Height
Principal Building	16.5 M	15 M

Units Count - Principal Building				
	Studio	One Bed.	One Bed. + Den	Two Bed.
Ground	-	8	-	2
2	2	7	3	4
3	2	7	3	4
4	-	7	3	5
5	-	7	3	5
Total units - Principal Building	4	36	12	20
Unit Mix %	6%	50%	17%	28%

Minimum required parking	Proposed parking		
1.6 spaces per dwelling unit in Residential Apartments Use	ADDITIONAL UNDERGROUND PARKADE	STANDARD	15
		SMALL CAR	11
1.6 spaces X 72 dwelling units= 115.2= 115 spaces	TOP OF SLAB SURFACE PARKING	STANDARD	29
		SMALL CAR	4
29 spaces for small cars = 20%	UNDERGROUND PARKING	STANDARD	38
		SMALL CAR	0
1 space per 23 m2 of gross commercial floor area	ORIGINAL SURFACE PARKING	STANDARD	21
		SMALL CAR	5
Total required 122 spaces	115 RESIDENTIAL + 7 COMMERCIAL = 122 spaces		

Parking Spaces for Persons with Disabilities	
Minimum required parking	Proposed parking
4	4 Spaces

Bicycle Parking	
Class I bicycle Parking	
Minimum required parking	Proposed parking
1.spaces per dwelling unit in Residential Apartments Zone	73 spaces
1 spaces X 72 dwelling units= 72 spaces	
50% of 1 per 250SM Gross Floor Area (GFA) for first 5000SM	
50% x (163/250)= 1 space	
Class II bicycle Parking	
Minimum required parking	Proposed parking
6 space rack at each entrance of a Residential Apartment Dwelling	12 spaces
6 x 1 =6 spaces	
50% of 1 per 250SM Gross Floor Area (GFA) for first 5000SM	
50% x (163/250)= 1 space	

CONSULTANT LIST

OWNER/ CLIENT
 Company DISTRICT GROUP
 Address 200 - 8809 HEATHER STREET, VANCOUVER, BC
 T: 604-322-5762

ARCHITECT
 Company Musson Cattell Mackey Partnership
 Address 1900 - 1066 West Hastings Street, Vancouver, BC.
 T: 604-687-2990

LANDSCAPE ARCHITECT
 Company LADR Landscape Architects Ltd.
 Address #3-864 Queens Ave. Victoria B.C.
 T: 250-598-0105

CIVIL CONSULTANT
 Company Aplin & Martin Consultants Ltd.
 Address 1818 - 1177 W Hastings St Suite 1818, Vancouver, BC.
 T: 604-678-9434

SURVEYOR
 Company Mollvaney Riley Land Surveying Inc.
 Address #113-2244 Sooke RD., Victoria, BC
 T: 250-474-5538

DRAWING INDEX

ARCHITECTURAL

SHEET #	DRAWING DESCRIPTION	SCALE																		
A001	COVER SHEET & PROJECT INFO.	N.T.S	●	●	●	●														
A1.01	OVERALL SITE PLAN	1/16"=1'-0"	●	●	●	●														
A003	LEVEL P1 (PARKING SITE PLAN)	1/16"=1'-0"	●	●	●	●														
A201	BUILDING FLOOR PLANS	1/8"=1'-0"	●	●	●	●														
A202	BUILDING FLOOR PLANS	1/8"=1'-0"	●	●	●	●														
A203	ROOF LEVEL	1/8"=1'-0"	●	●	●	●														
A301	BUILDING ELEVATIONS	1/8"=1'-0"	●	●	●	●														
A302	BUILDING ELEVATIONS	1/8"=1'-0"	●	●	●	●														
A303	BUILDING ELEVATIONS	1/8"=1'-0"	●	●	●	●														
A315	WASTE AND RECYCLING ENCLOSURE ELEVATIONS	3/8"=1'-0"	●	●	●	●														
A321	BUILDING SECTIONS	1/16"=1'-0"	●	●	●	●														
A380	MATERIAL BOARD	N.T.S	●	●	●	●														
A2.02	LOWER LEVEL- NEW PARKING	1/8"=1'-0"																		
A2.03	UPPER LEVEL- NEW PARKING	1/8"=1'-0"																		

LANDSCAPE

LANDSCAPE	LANDSCAPE CONCEPT PLAN		●	●	●	●														
	LANDSCAPE LIGHTING PLAN																			

CIVIL

18-5199-00	COVER	N.T.S	●	●																
18-5199-01	GENERAL NOTES	N.T.S	●	●																
18-5199-02	KEY PLAN	1:250 METRIC	●	●																
18-5199-03	GRADING PLAN	1:250 METRIC	●	●																
18-5199-04	SERVICING PLAN	1:250 METRIC	●	●																
18-5199-05	STORM D1-D2 PLAN & PROFILE	1:250 METRIC	●	●																
18-5199-06	EAST STORM & SANITARY PLAN & PROFILE	1:250 METRIC	●	●																
18-5199-07	CENTER PARKING AREA PLAN & PROFILE	1:250 METRIC	●	●																
18-5199-08	PARKADE RAMP PLAN & PROFILE	1:250 METRIC	●	●																
18-5199-09	NORTH PARKING PLAN & PROFILE	1:250 METRIC	●	●																
18-5199-10	FIRE PLAN	1:250 METRIC	●	●																
18-5199-11	WEST CROSS - SECTIONS	1:250 METRIC	●	●																
18-5199-12	SOUTH CROSS - SECTIONS	1:250 METRIC	●	●																
18-5199-13	DETAILS	N.T.S	●	●																
18-5199-14	STORMWATER MANAGEMENT PLAN	1:250 METRIC	●	●																
18-5199	FIRE FLOW CALCULATION	N.T.S	●	●																

SURVEY

6174 SITE			●	●																
-----------	--	--	---	---	--	--	--	--	--	--	--	--	--	--	--	--	--	--	--	--


15 MAY 2020 ISSUED FOR DEVELOPMENT'S PERMIT
 10 AUGUST 2020 RE-ISSUED FOR DEVELOPMENT'S PERMIT
 27 JULY 2022 ISSUED FOR DEVELOPMENT'S PERMIT MA
 06 OCTOBER 2023 ISSUED FOR DEVELOPMENT'S PERMIT MA

ISSUE LOG

ISSUE LOG KEY:

● " DENOTES ISSUED AS PART OF SET

SITE CONTEXT

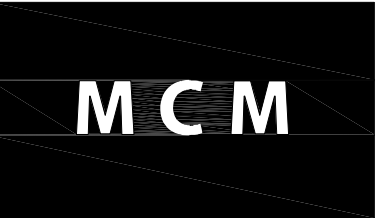

Musson Cattell Mackey Partnership

Architects Designers Planners

Oceanic Plaza
 1066 West Hastings Street
 Suite 1900
 Vancouver, British Columbia
 Canada V6E 3X1
 T. 604. 687. 2990
 F. 604. 687. 1771
 MCMPartners.com

200-8809 Heather Street,
 Vancouver,
 British Columbia
 Canada V6P 3T1
 T.604.322.5762
 districtgroup.ca

2023 OCTOBER 06
 Issued for Development Permit MA


Revisions YYYY-MM-DD

Seal
360 LATORIA BLVD. COLWOOD

Project
PROJECT INFORMATION


Drawing
 Scale
 Project
 Sheet **A001**

A
 PLAN VIP82319

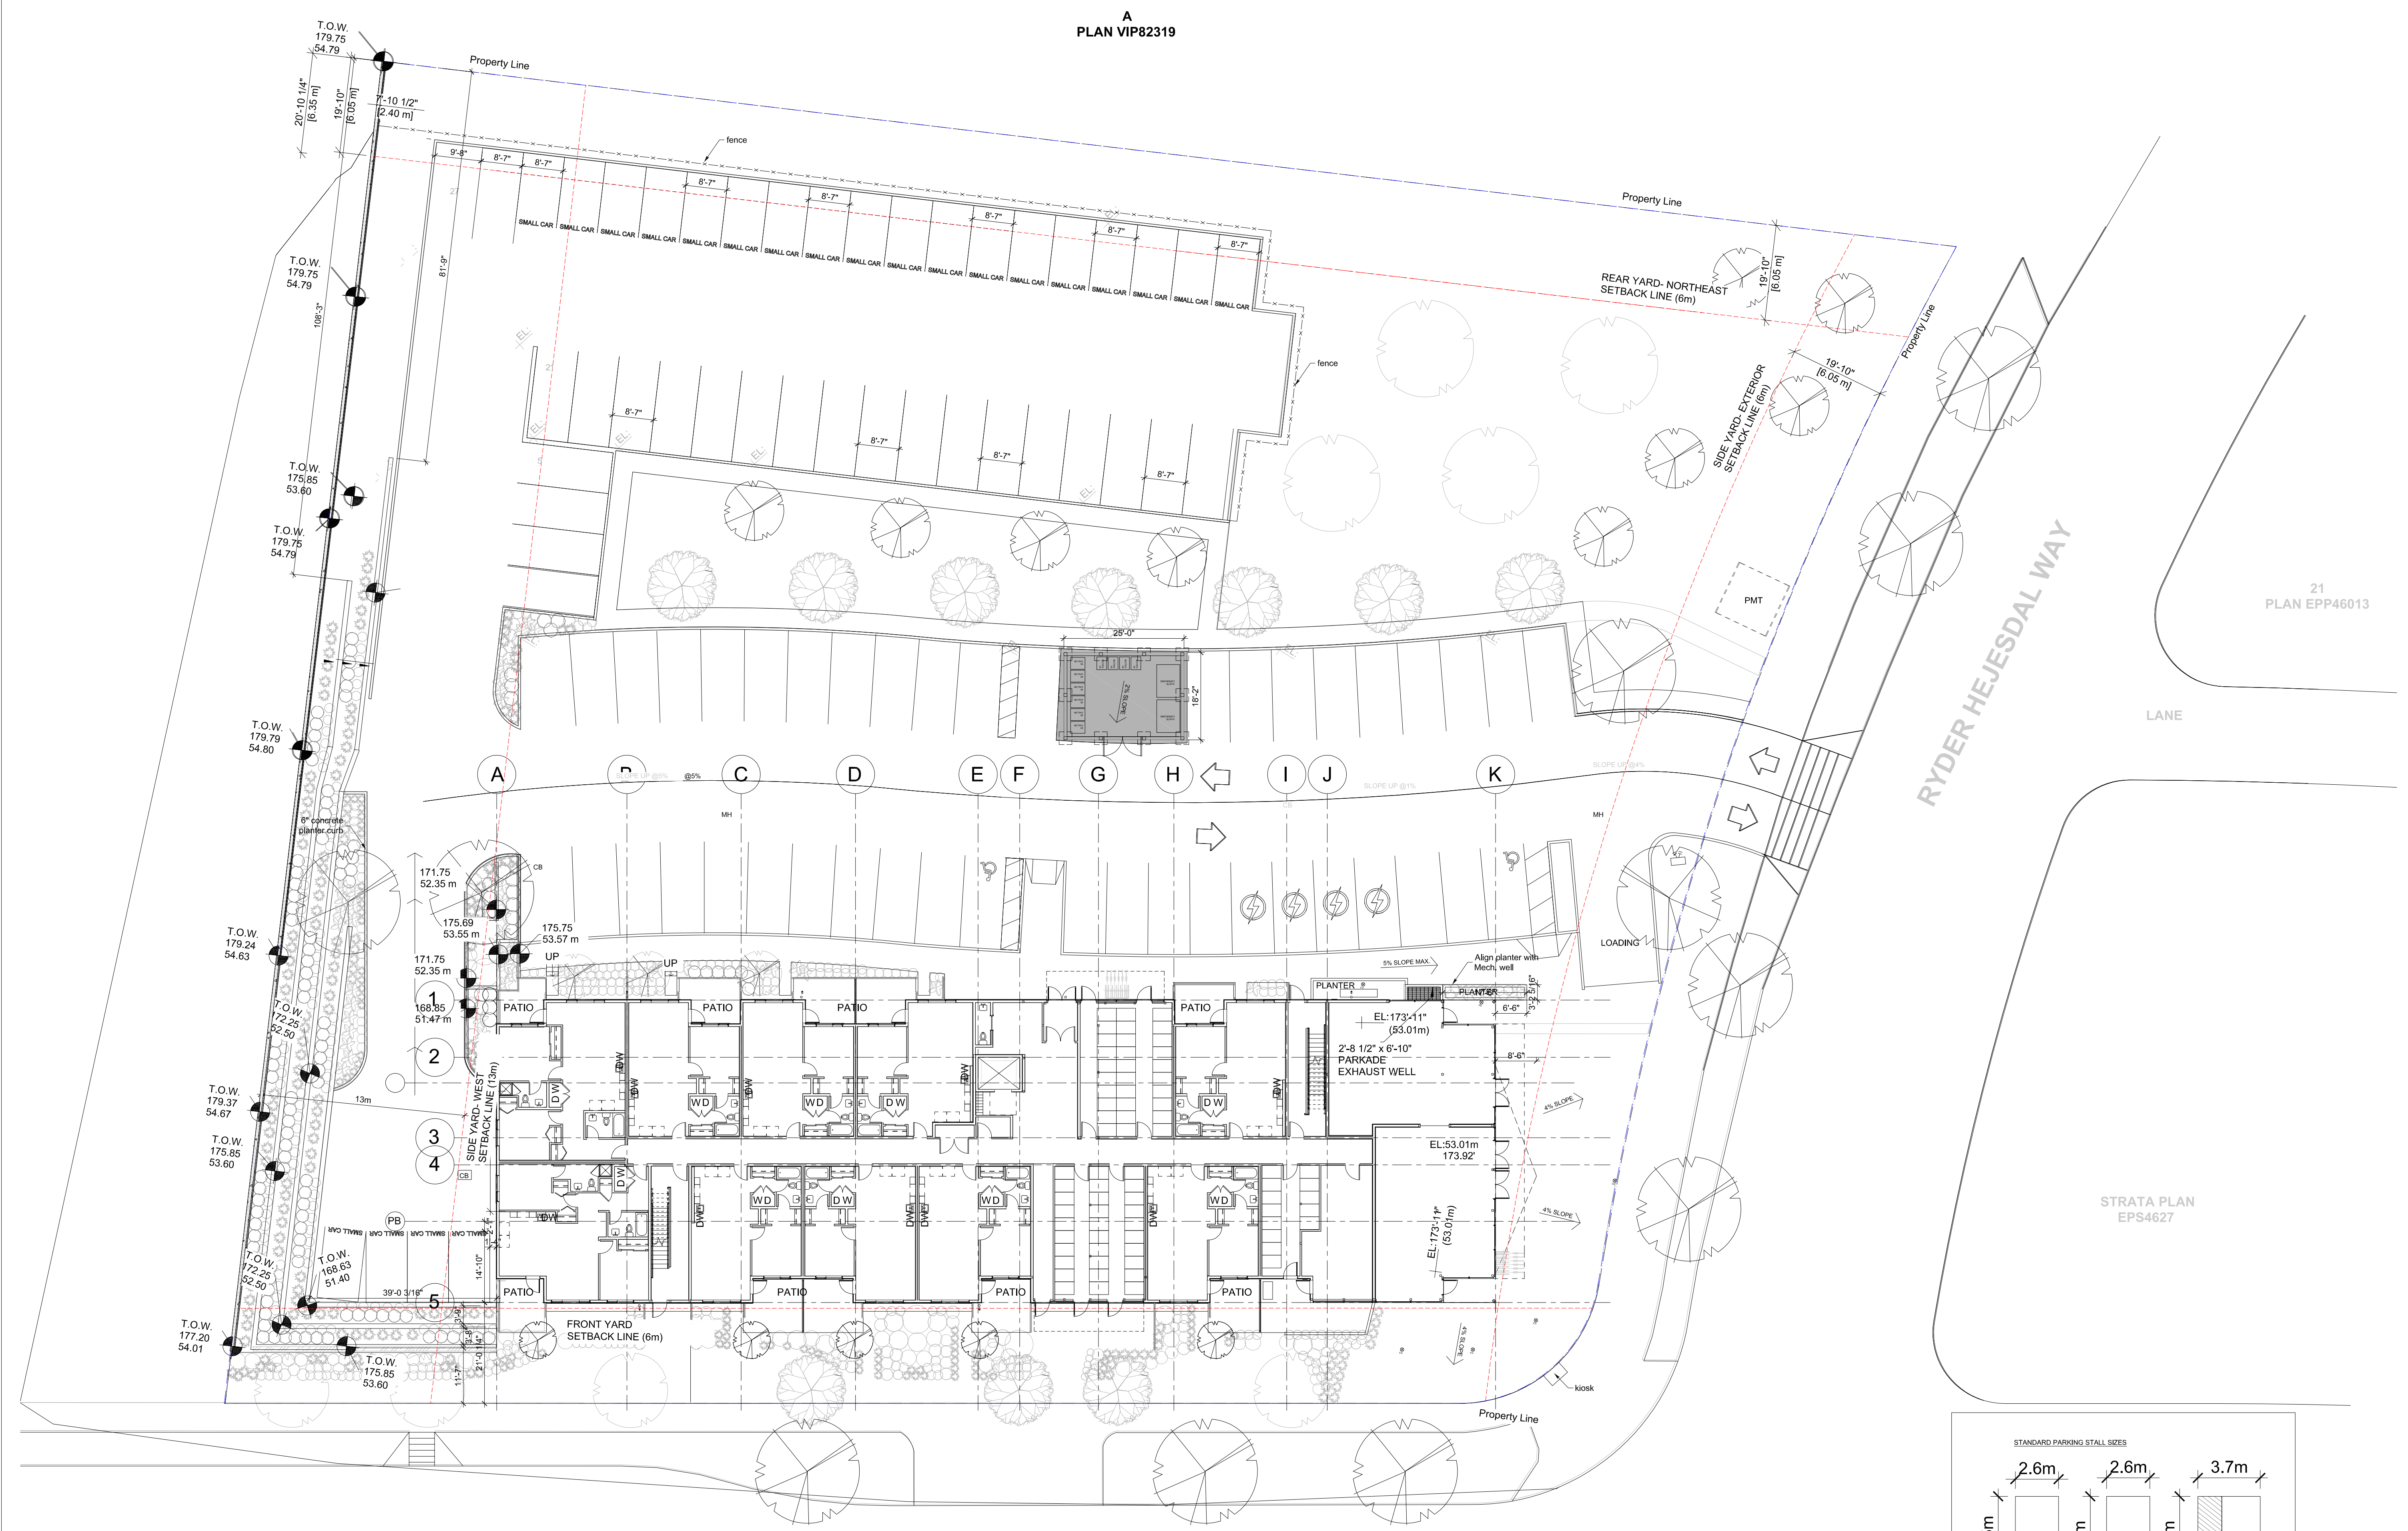


LATORIA BOULEVARD

RYDER HEJESDAL WAY

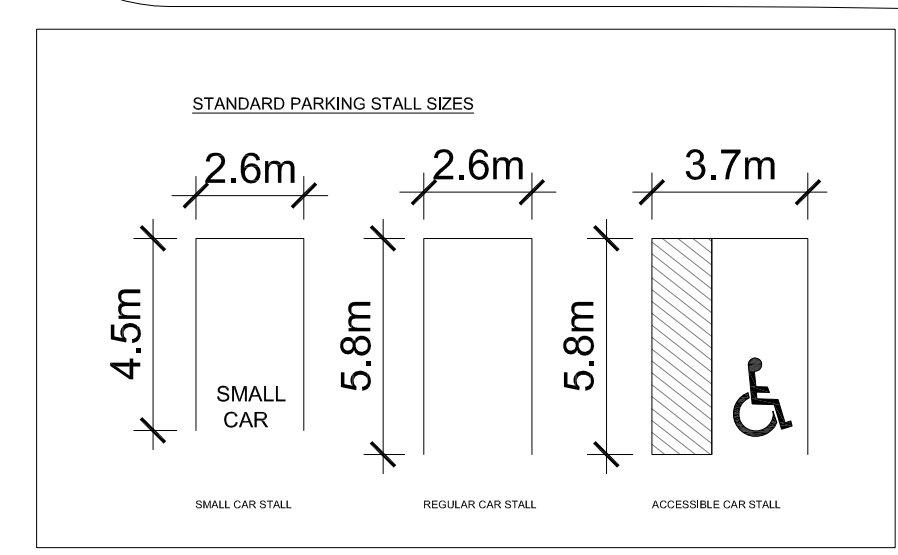

1 OVERALL SITE PLAN
 A1.01 SCALE - 1/16" = 1'-0"


2022-05-19 3:49:24 PM

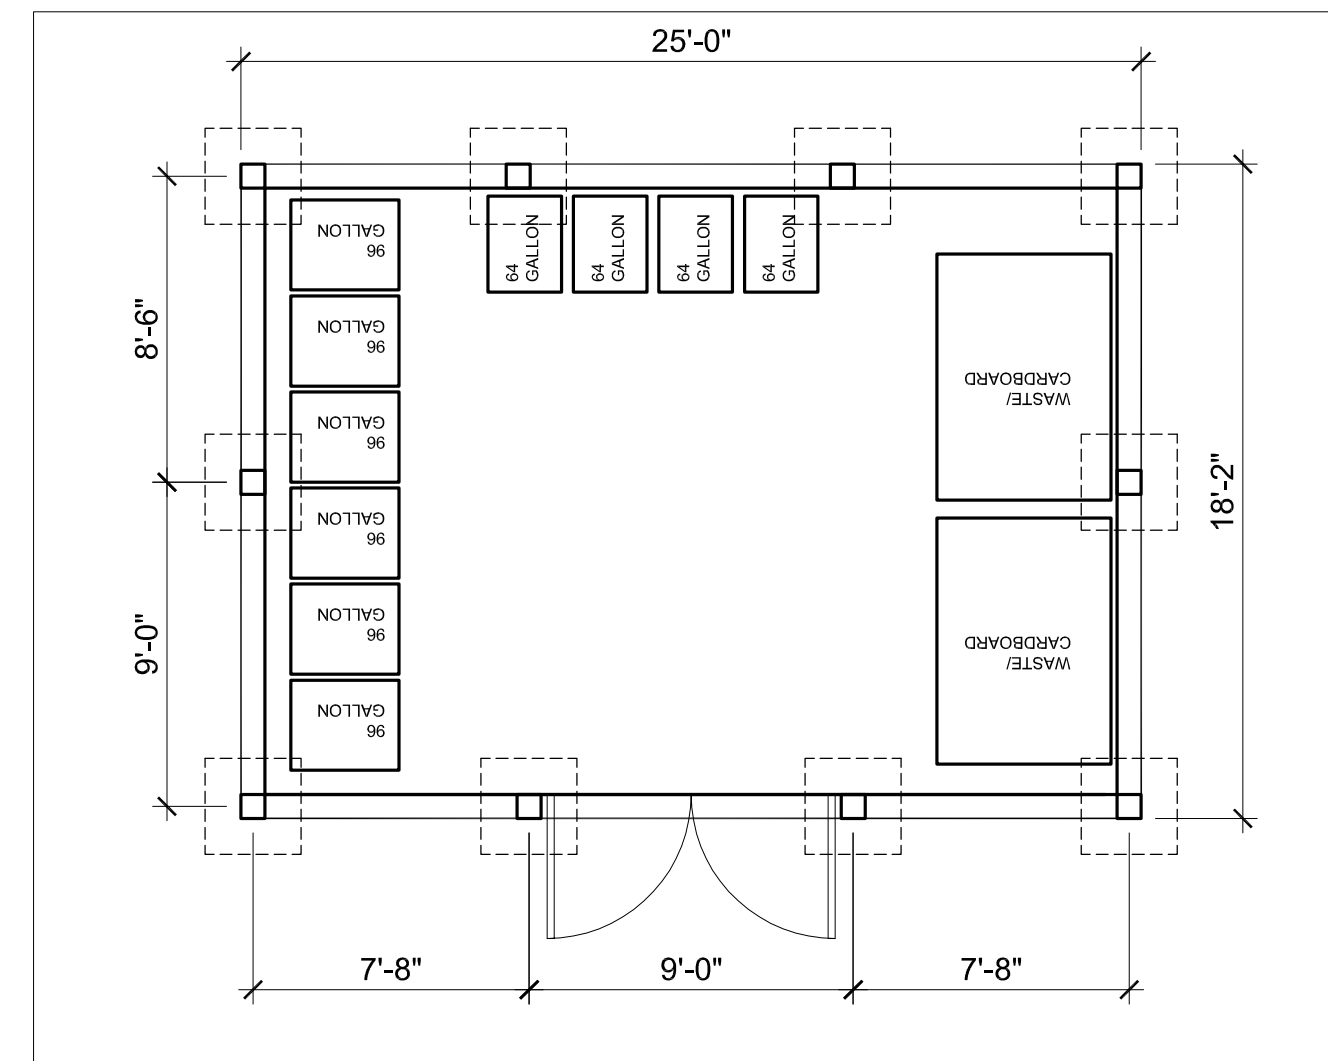


**MATERIALS
LEGEND**

- C-1 CEMENT PANEL - DARK GRAY
- M-1 METAL PICKET DOOR
- M-2 METAL CAP


5 FLOOR PLAN
A315 3/16" = 1'

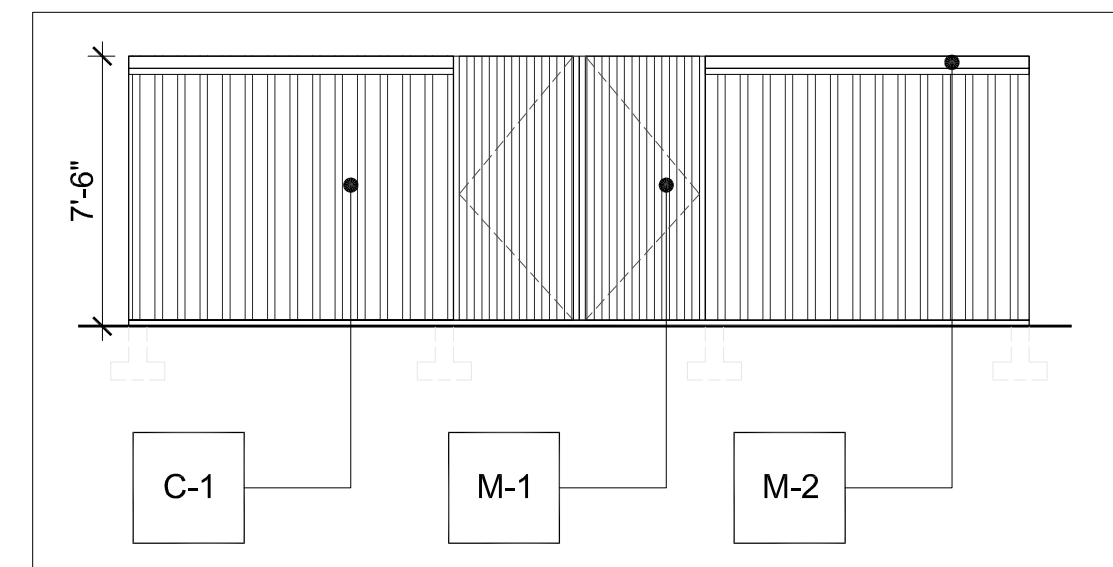


1 NORTH ELEVATION
A315 3/16" = 1'

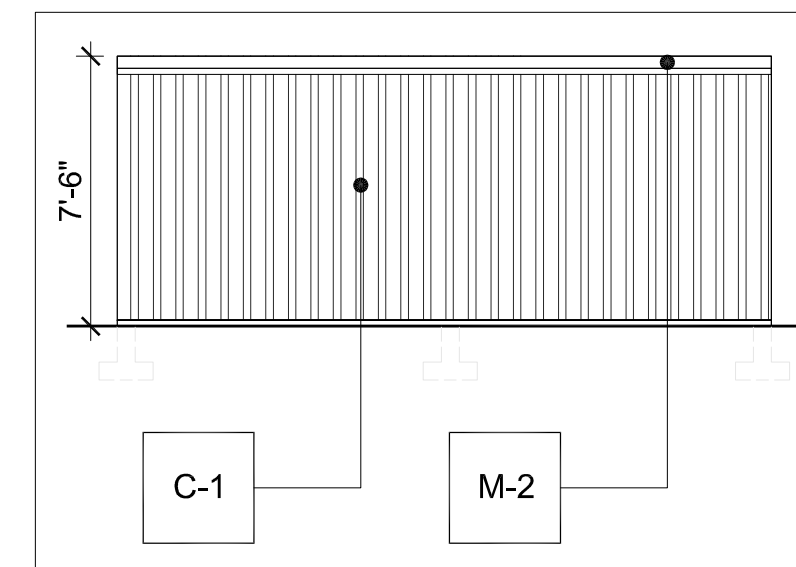

2 EAST ELEVATION
A315 3/16" = 1'

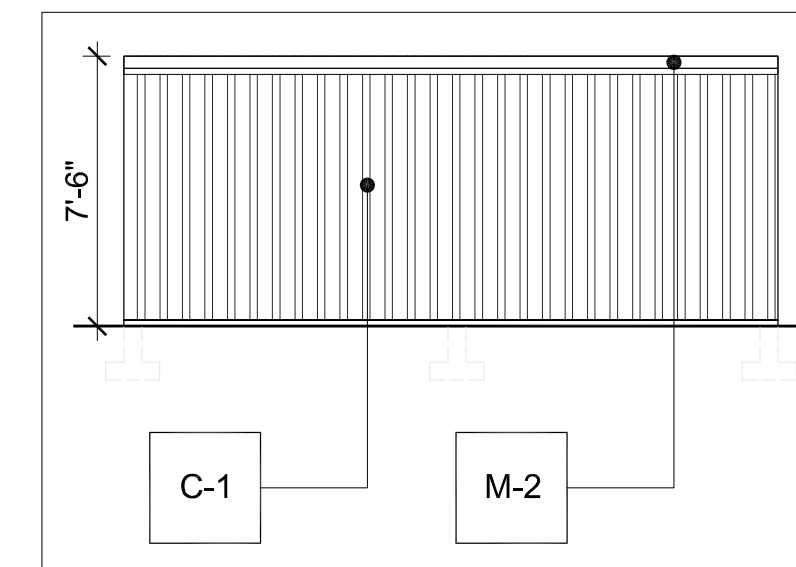

3 WEST ELEVATION
A315 3/16" = 1'

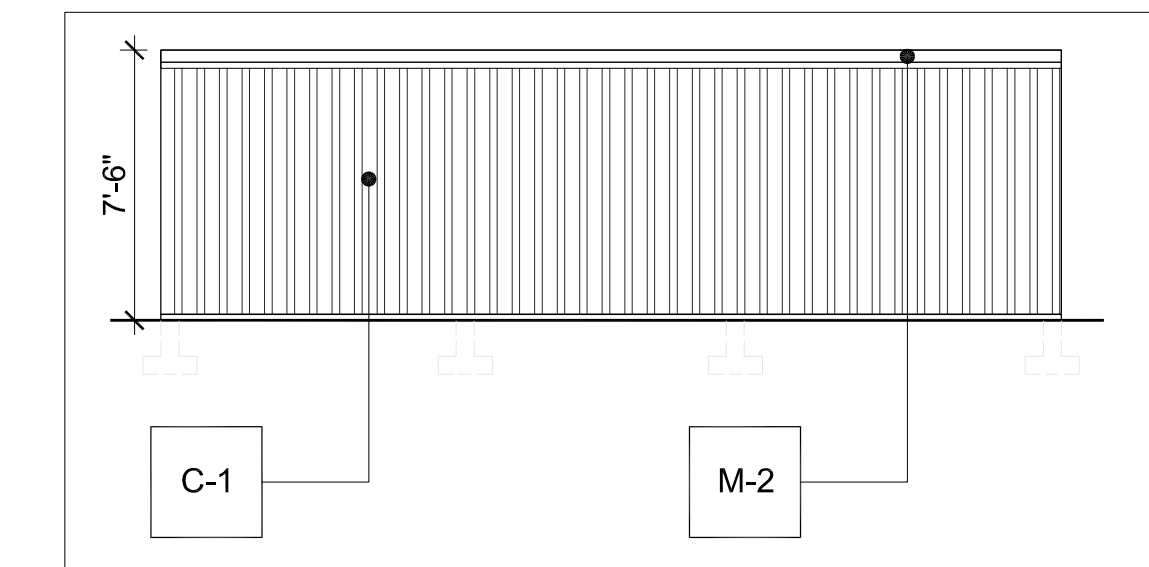

4 SOUTH ELEVATION
A315 3/16" = 1'

2023 OCTOBER 06
Issued for Development Permit MA

Revisions
YYYY-MM-DD


Seal
COLWOOD


Project
**RECYCLING
ENCLOSURE**

Drawing
Scale 3/16" = 1'-0"

Project 218071

Sheet **A315**

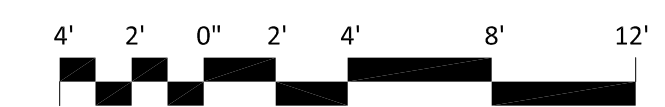

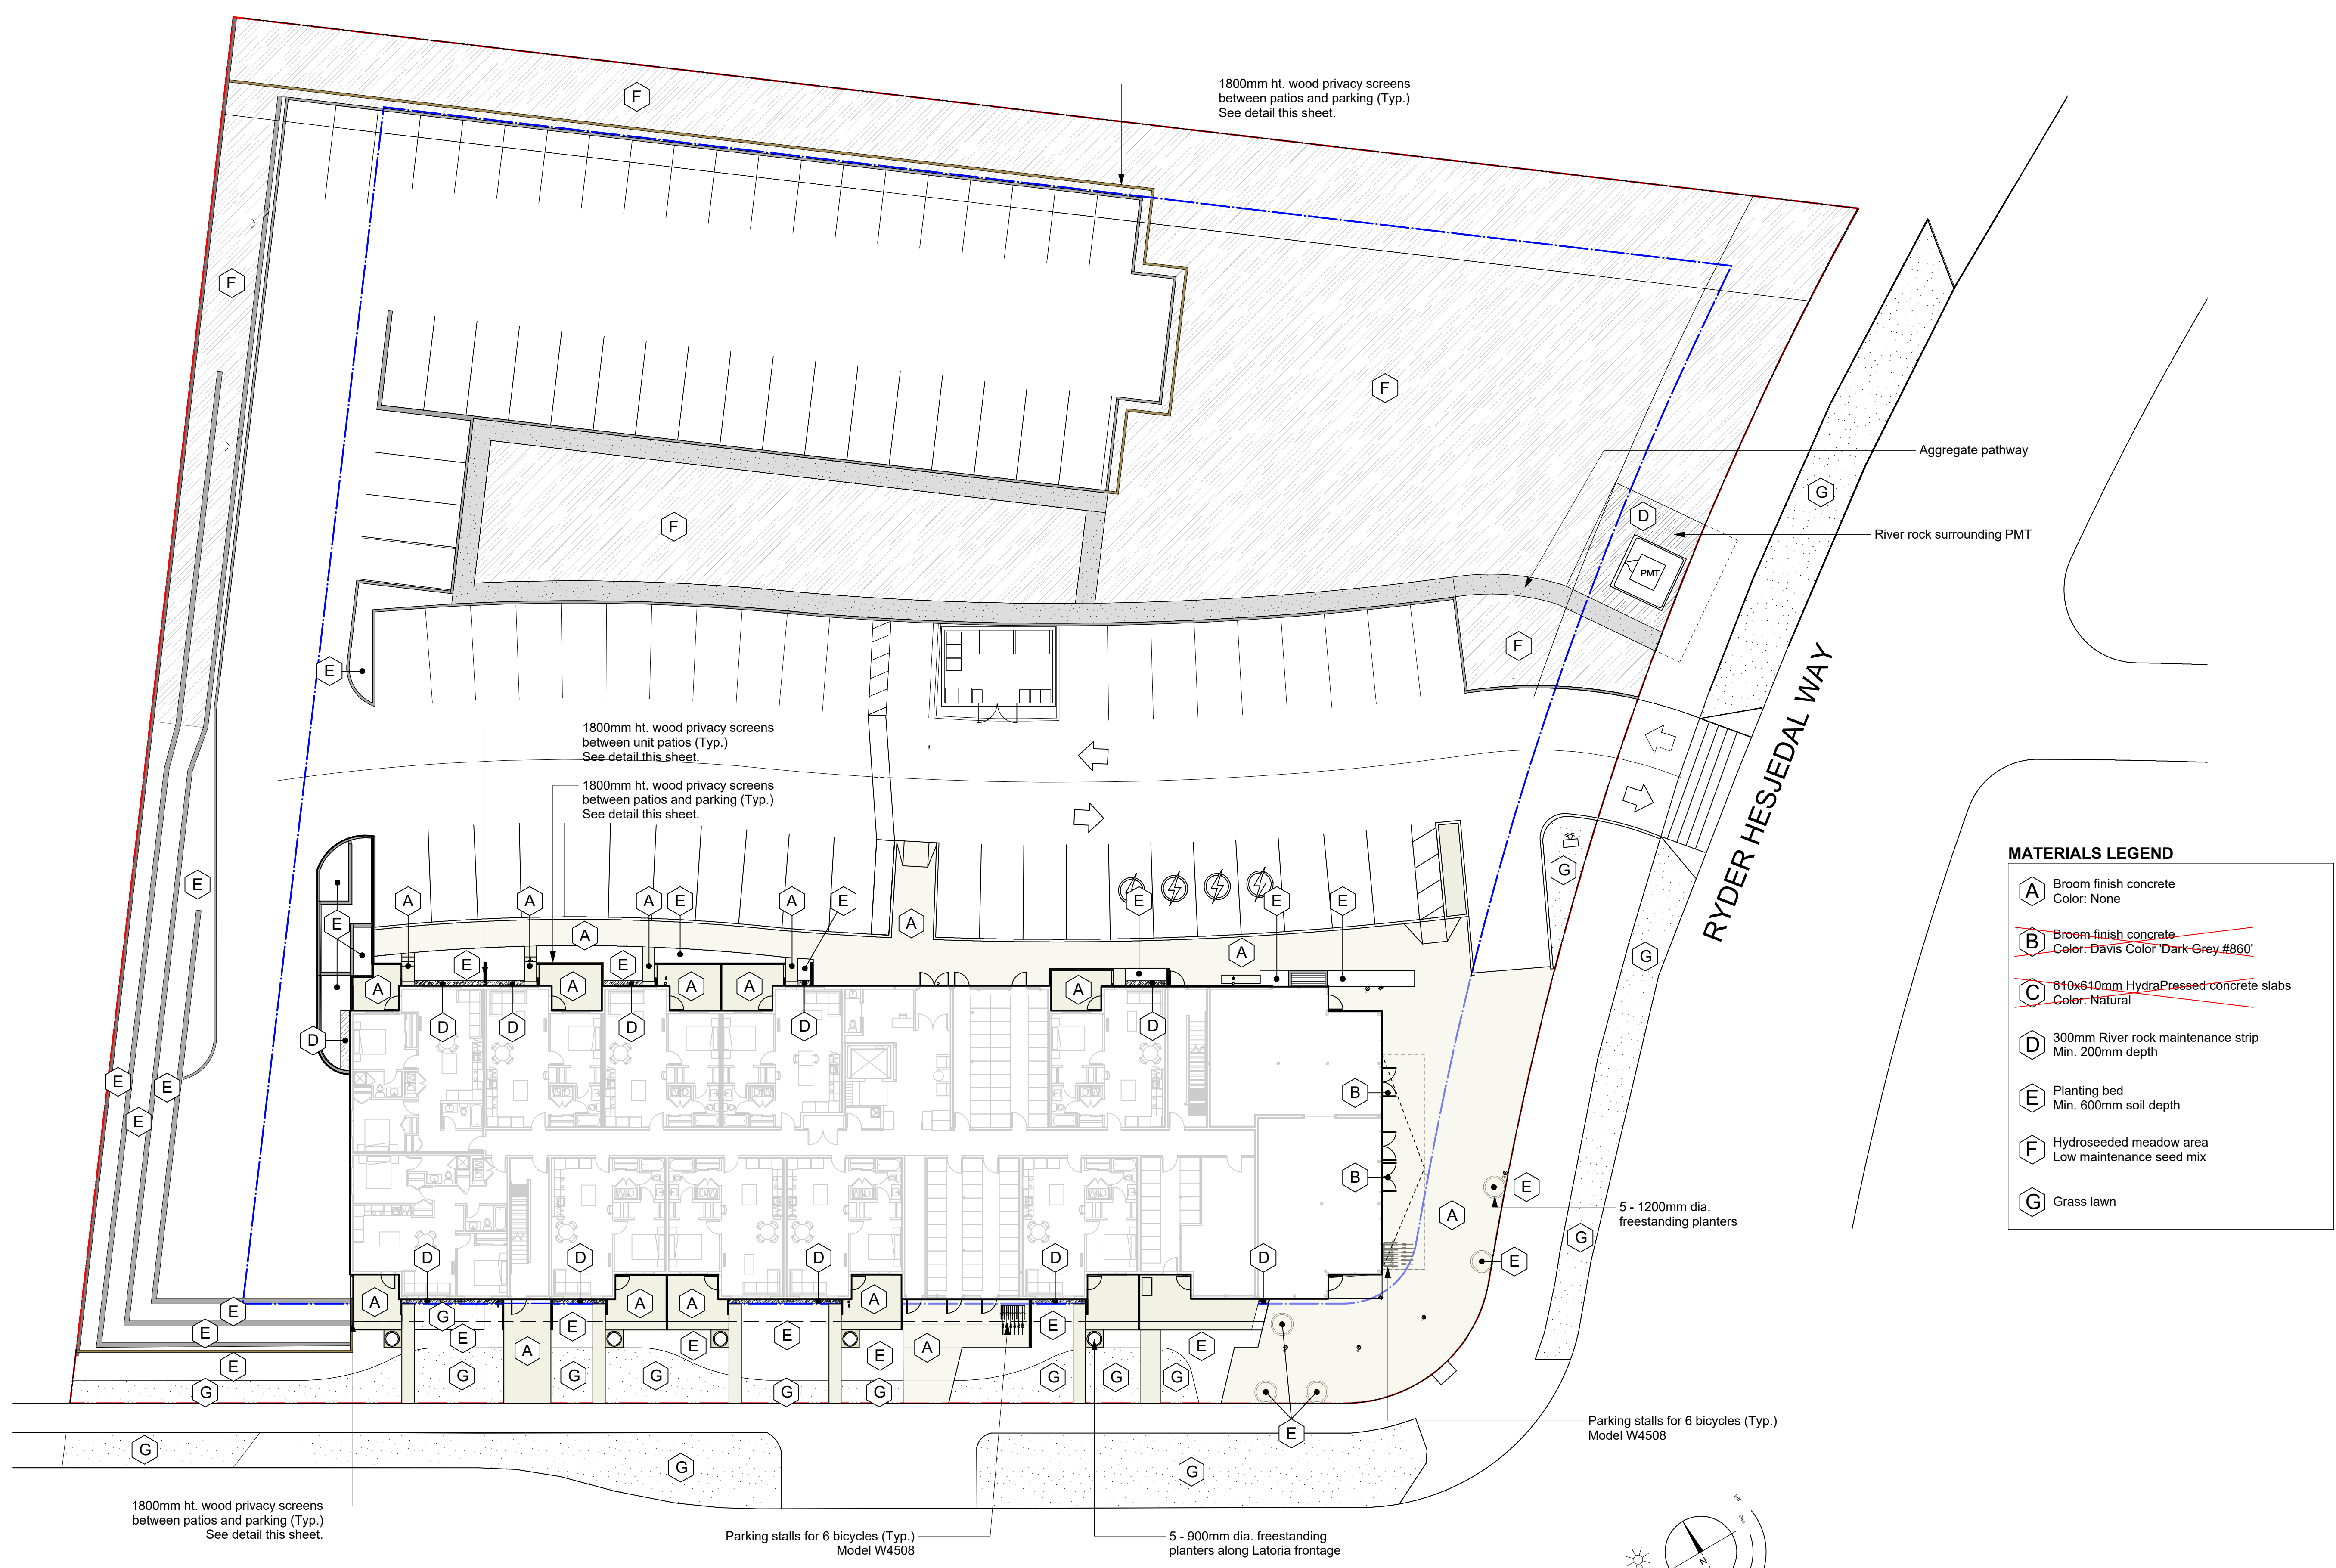


MATERIALS LEGEND

- A** Broom finish concrete
Color: None
- ~~**B** Broom finish concrete
Color: Davis Color 'Dark Grey #860'~~
- ~~**C** 610x610mm HydraPressed concrete slabs
Color: Natural~~
- D** 300mm River rock maintenance strip
Min. 200mm depth
- E** Planting bed
Min. 600mm soil depth
- F** Hydroseeded meadow area
Low maintenance seed mix
- G** Grass lawn

NO.	DATE	DESCRIPTION
7	Oct 05-23	As-Built
6	Dec 21-22	Re-issued for Construction
5	Oct 05-22	Issued for Site Instruction No. 2
4	Sep 16-22	Re-issued for Construction
3	Apr 13-21	PMT Notes Added
2	Jan 18-21	Issued for Construction
1	Sept 29-20	Issued for FT

REVISIONS



#3-864 Queens Ave. Victoria B.C. V8T 1M5
Phone: (250) 598-0105

PROJECT
3554 Ryder Hesjedal Way
 Royal Bay
 Colwood, BC

TITLE
Landscape Materials Plan

SCALE
1:200

DRAWN **CW**
 CHECKED **BW**


PROJECT No. **2003**


DATE
Aug 24-20

L1 of 4
 SHEET

1 Landscape Materials Plan
 L1 1:200



LATORIA BOULEVARD

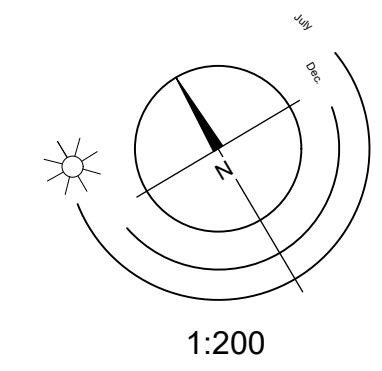

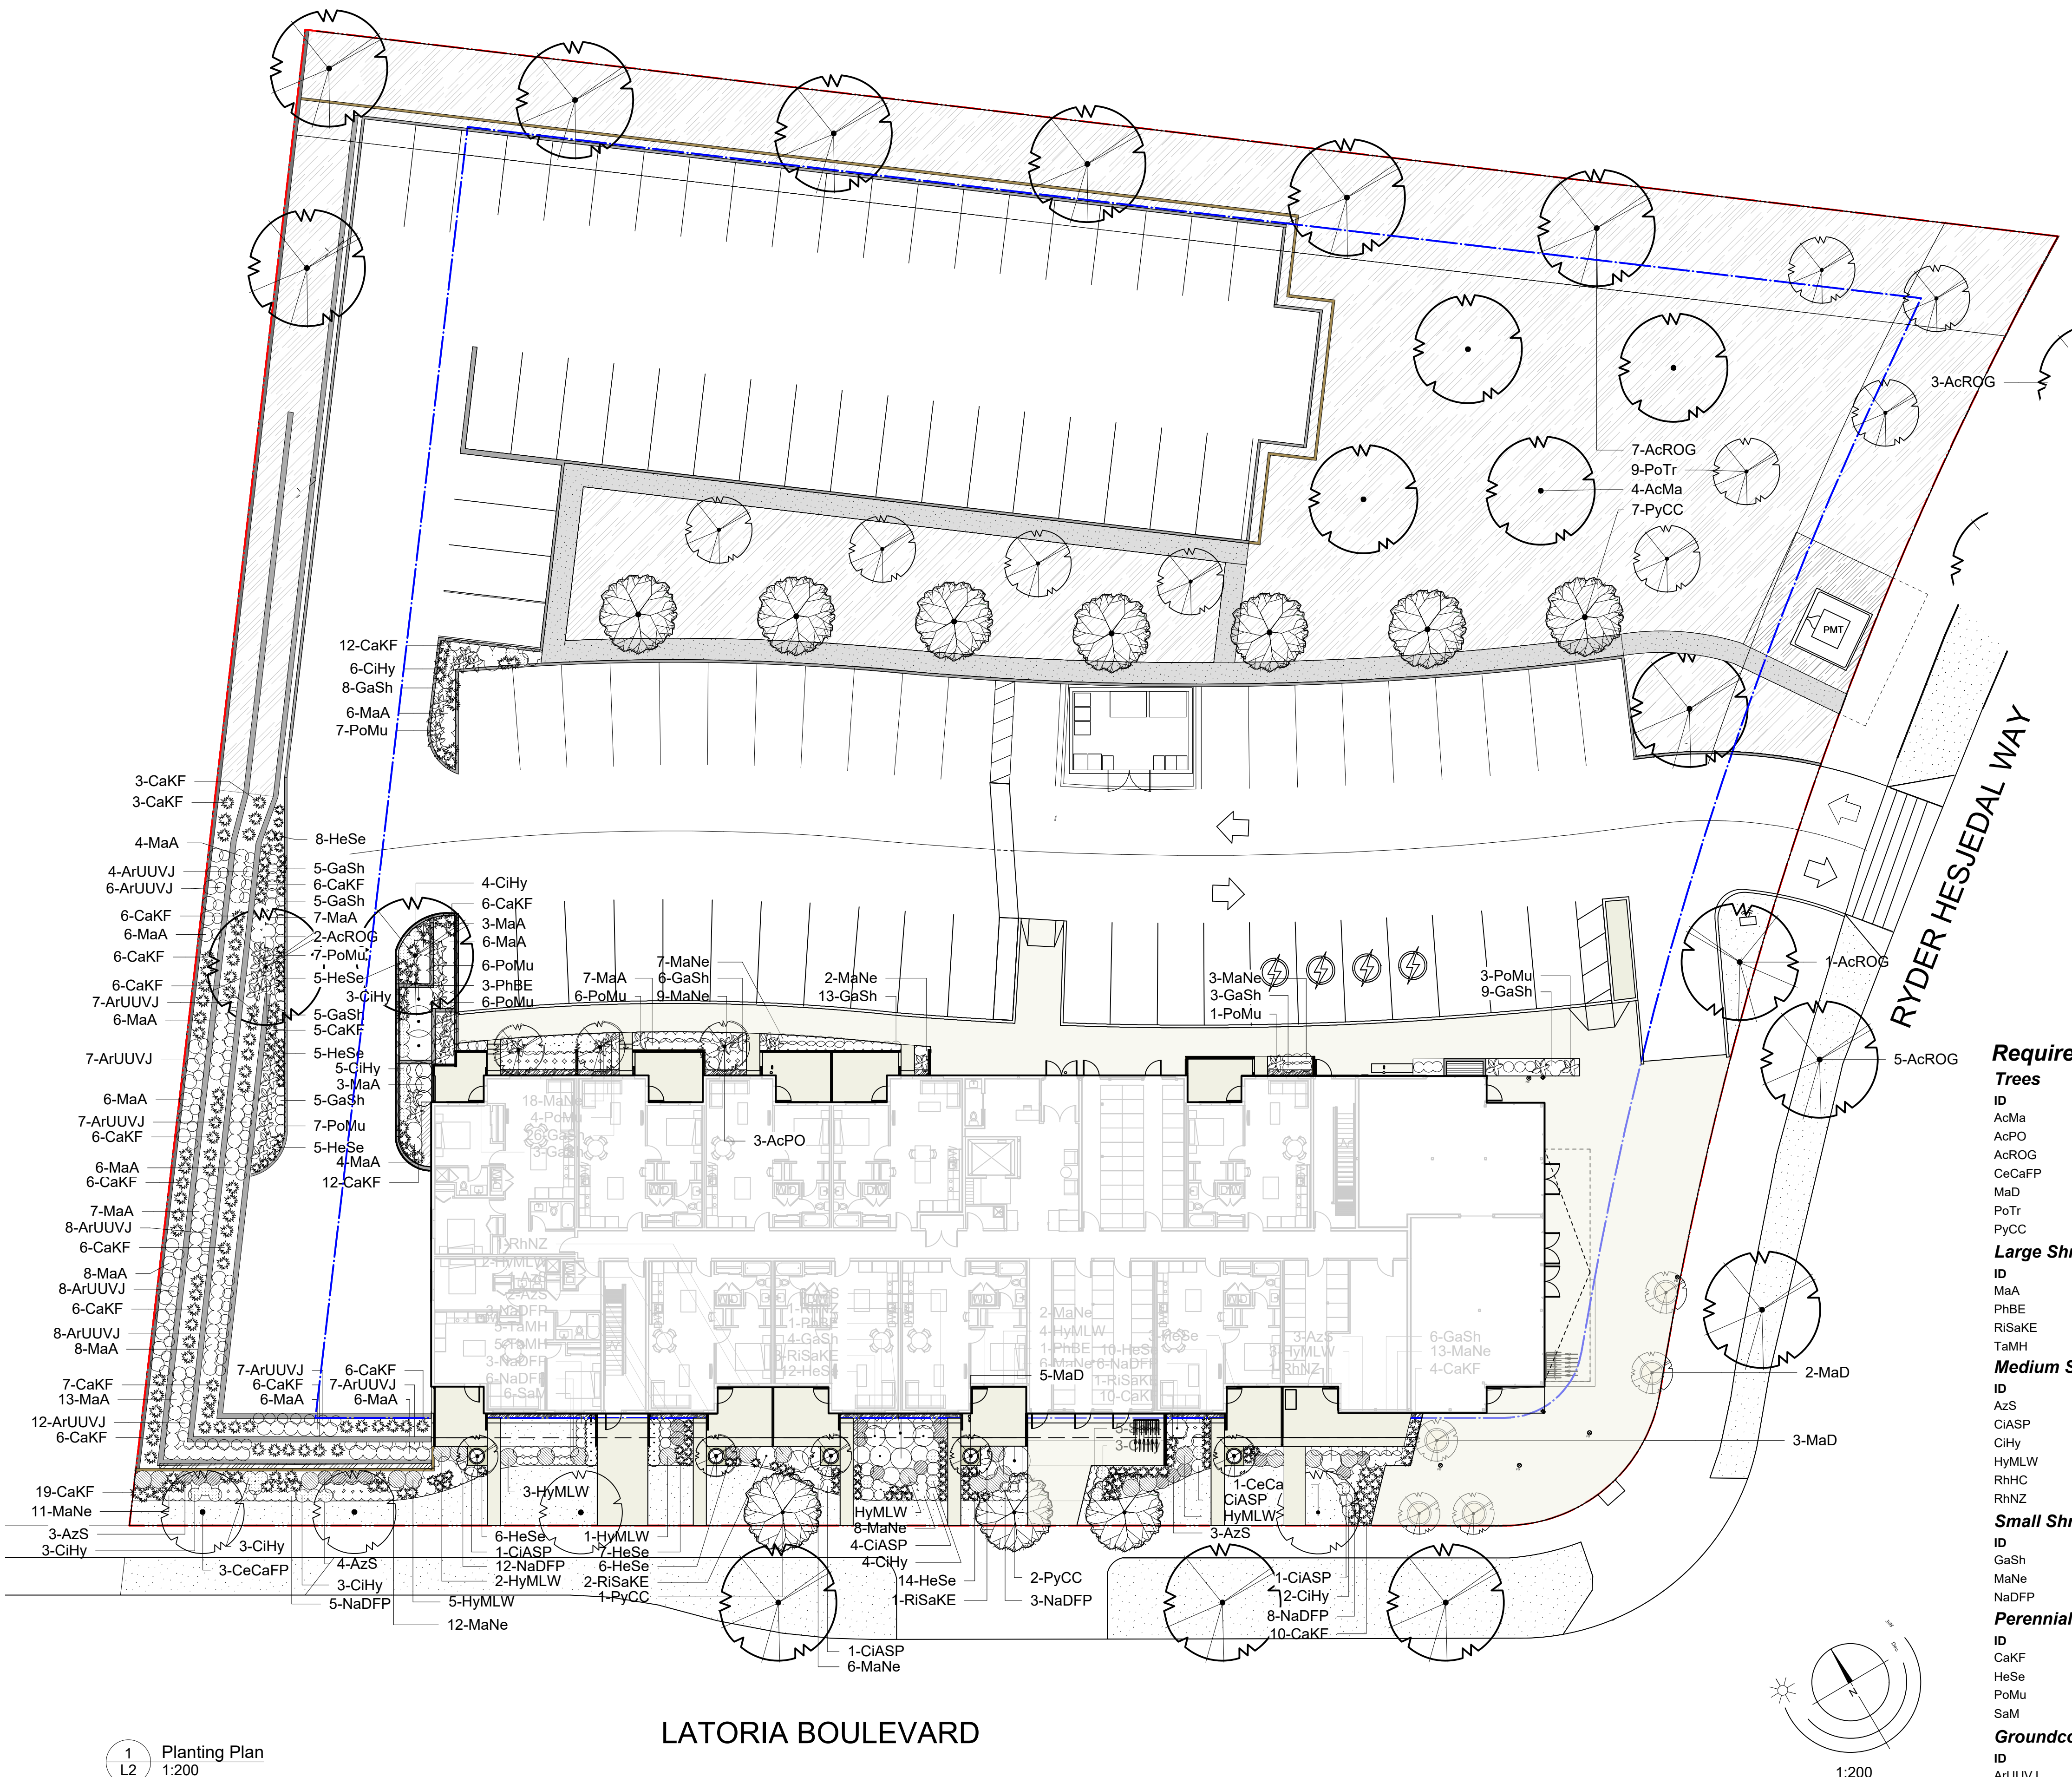


1 Planting Plan
L2 1:200


LATORIA BOULEVARD

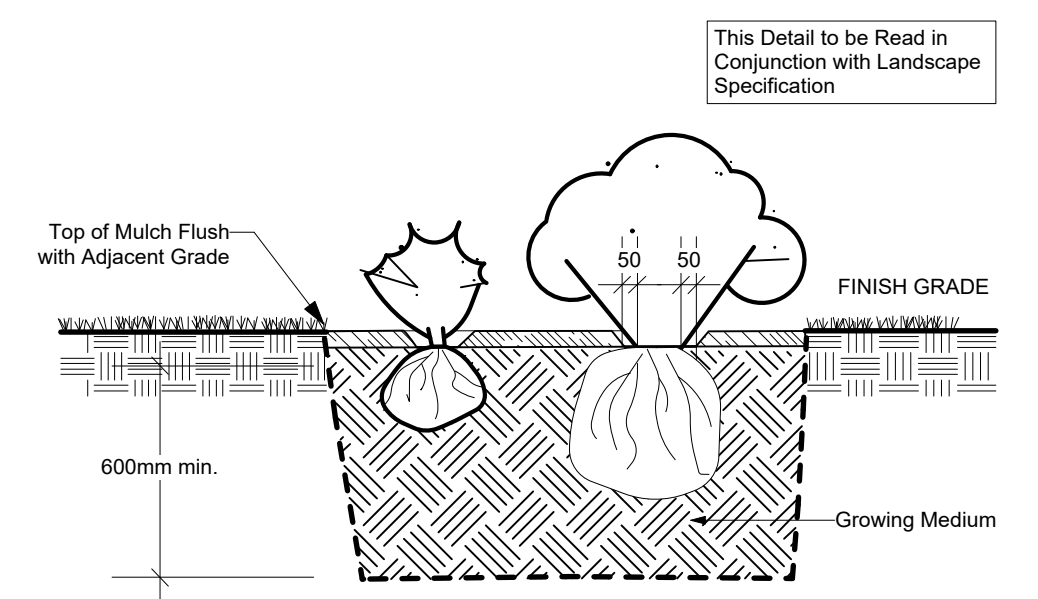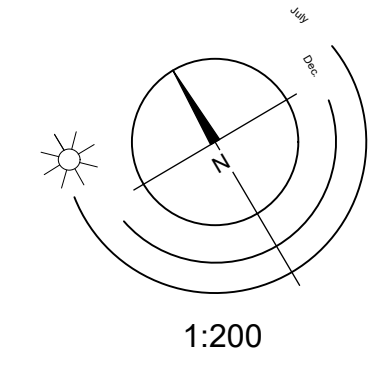

2 Shrub Planting - Typical Detail
L2 1:25

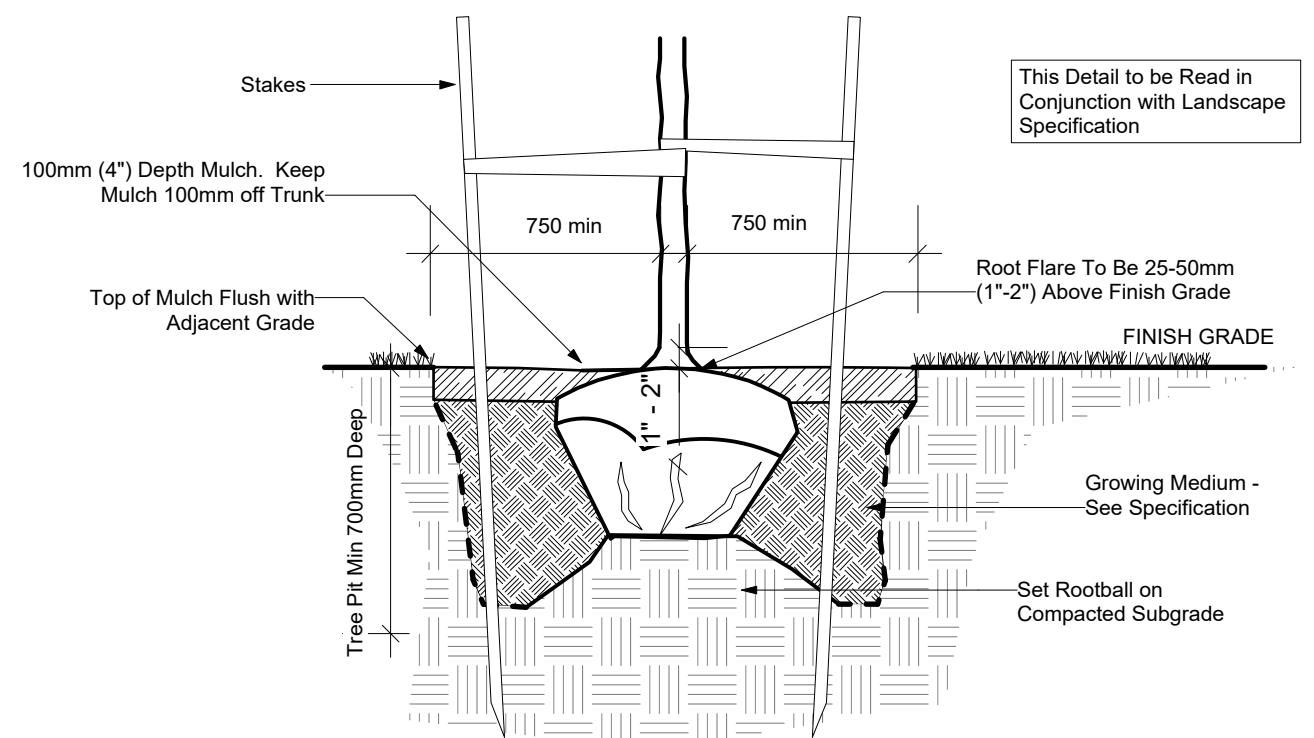

3 Tree Staking - Typical Detail
L2 1:25

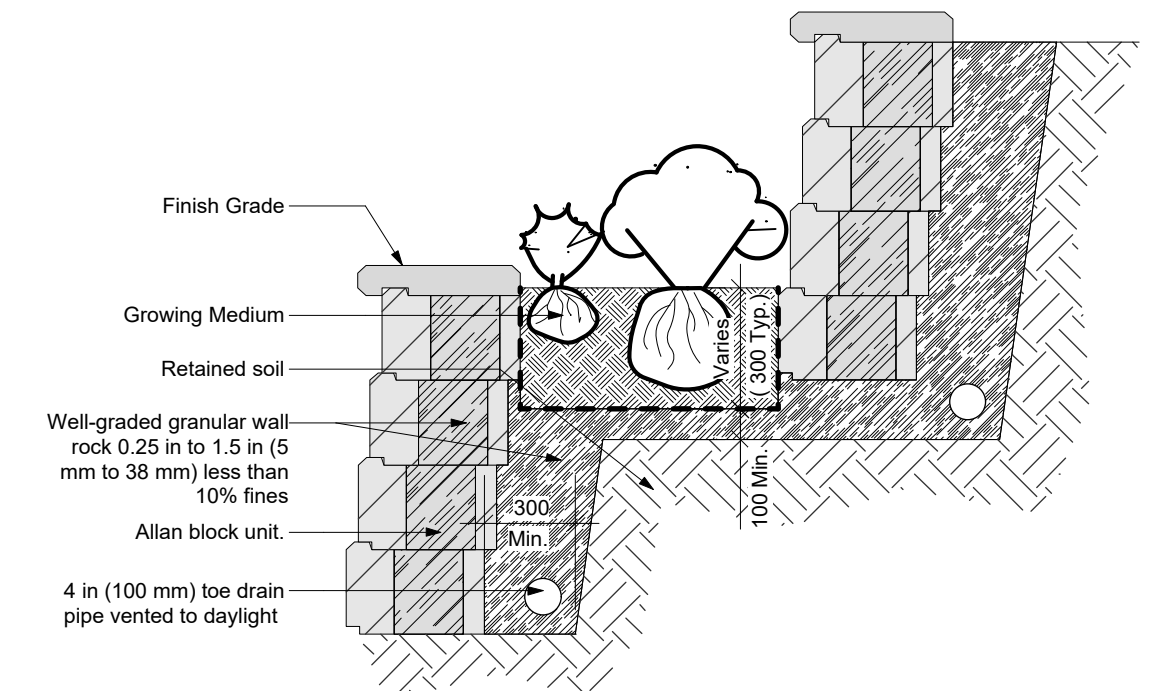

4 Allen Block wall - Typical Detail
L2 1:25

Required Plant List

ID	Quantity	Botanical Name	Common Name	Size
Trees				
AcMa	4	Acer macrophyllum	Big Leaf Maple	6cm cal.
AcPO	3	Acer palmatum 'Osakazuki'	Osakazuki Japanese Maple	6cm cal.
AcROG	10	Acer rubrum 'October Glory'	October Glory Red Maple	6cm cal.
CeCaFP	4	Cercis canadensis 'Forest Pansy'	Forest Pansy Redbud	6cm cal.
MaD	10	Magnolia 'Daybreak'	Daybreak Magnolia	6cm cal.
PoTr	9	Populus tremuloides	Quaking Aspen	6cm cal.
PyCC	10	Pyrus calleryana 'Chanticleer'	Callery Pear	6cm cal.
Large Shrubs				
MaA	112	Mahonia aquifolium	Tall Oregon Grape	#5 pot
PhBE	5	Philadelphus 'Belle Etoile'	Belle Etoile Mock Orange	#10 pot
RiSaKE	7	Ribes sanguineum 'King Edward VII'	King Edward VII Flowering Currant	#5 pot
TaMH	10	Taxus x media 'Hicksii'	Hicks Yew	1.5m ht.
Medium Shrubs				
AzS	22	Azalea 'Snowbird'	Snowbird Azalea	#5 pot
CIASP	10	Cistus x argenteus 'Silver Pink'	Silver Pink Rock Rose	#5 pot
CIHy	36	Cistus x hybridus	White Rockrose	#5 pot
HyMLW	24	Hydrangea macrophylla 'Lanarth White'	Lanarth White Hydrangea	#7 pot
RhHC	3	Rhododendron 'Hino-crimson'	Evergreen Azalea	#5 pot
RhNZ	3	Rhododendron 'Nova Zembla'	Nova Zembla Rhododendron	#7 pot
Small Shrubs				
GaSh	98	Gaultheria shallon	Salal	#1 pot
MaNe	97	Mahonia nervosa	Low Oregon Grape	#1 pot
NaDFP	46	Nandina domestica 'Fire Power'	Fire Power Heavenly Bamboo	#1 pot
Perennials, Annuals and Ferns				
CaKF	157	Calamagrostis x acutiflora 'Karl Foerster'	Karl Foerster Feather Reed Grass	#1 pot
HeSe	81	Helictotrichon sempervirens	Blue Oat Grass	#1 pot
PoMu	47	Polystichum munitum	Sword Fern	#1 pot
SaM	11	Salvia mainacht	May Night Sage	#1 pot
Groundcovers				
ArUUUVJ	81	Arctostaphylos uva ursi 'Vancouver Jade'	Vancouver Jade Kinnickinnick	#1 pot

Notes:
1. All work to be completed to current BCSLA Landscape Standards
2. All soft landscape to be irrigated with an automatic irrigation system

Rev	Date	Description
7	Oct 05-23	As-Built
6	Dec 21-22	Re-issued for Construction
5	Oct 05-22	Issued for Site Instruction No. 2
4	Sep 16-22	Re-issued for Construction
3	Apr 13-21	PMT Notes Added
2	Jan 18-21	Issued for Construction
1	Sept 29-20	Issued for FT

REVISIONS

#3-864 Queens Ave. Victoria B.C. V8T 1M5
Phone: (250) 598-0105


PROJECT
3554 Ryder Hesjedal Way
Royal Bay
Colwood, BC

TITLE
Landscape Planting Plan

SCALE **1:200** DRAWN **CW**
CHECKED **BW**

PROJECT No. **2003**

DATE **Aug 24-20** SHEET **L2 of 4**

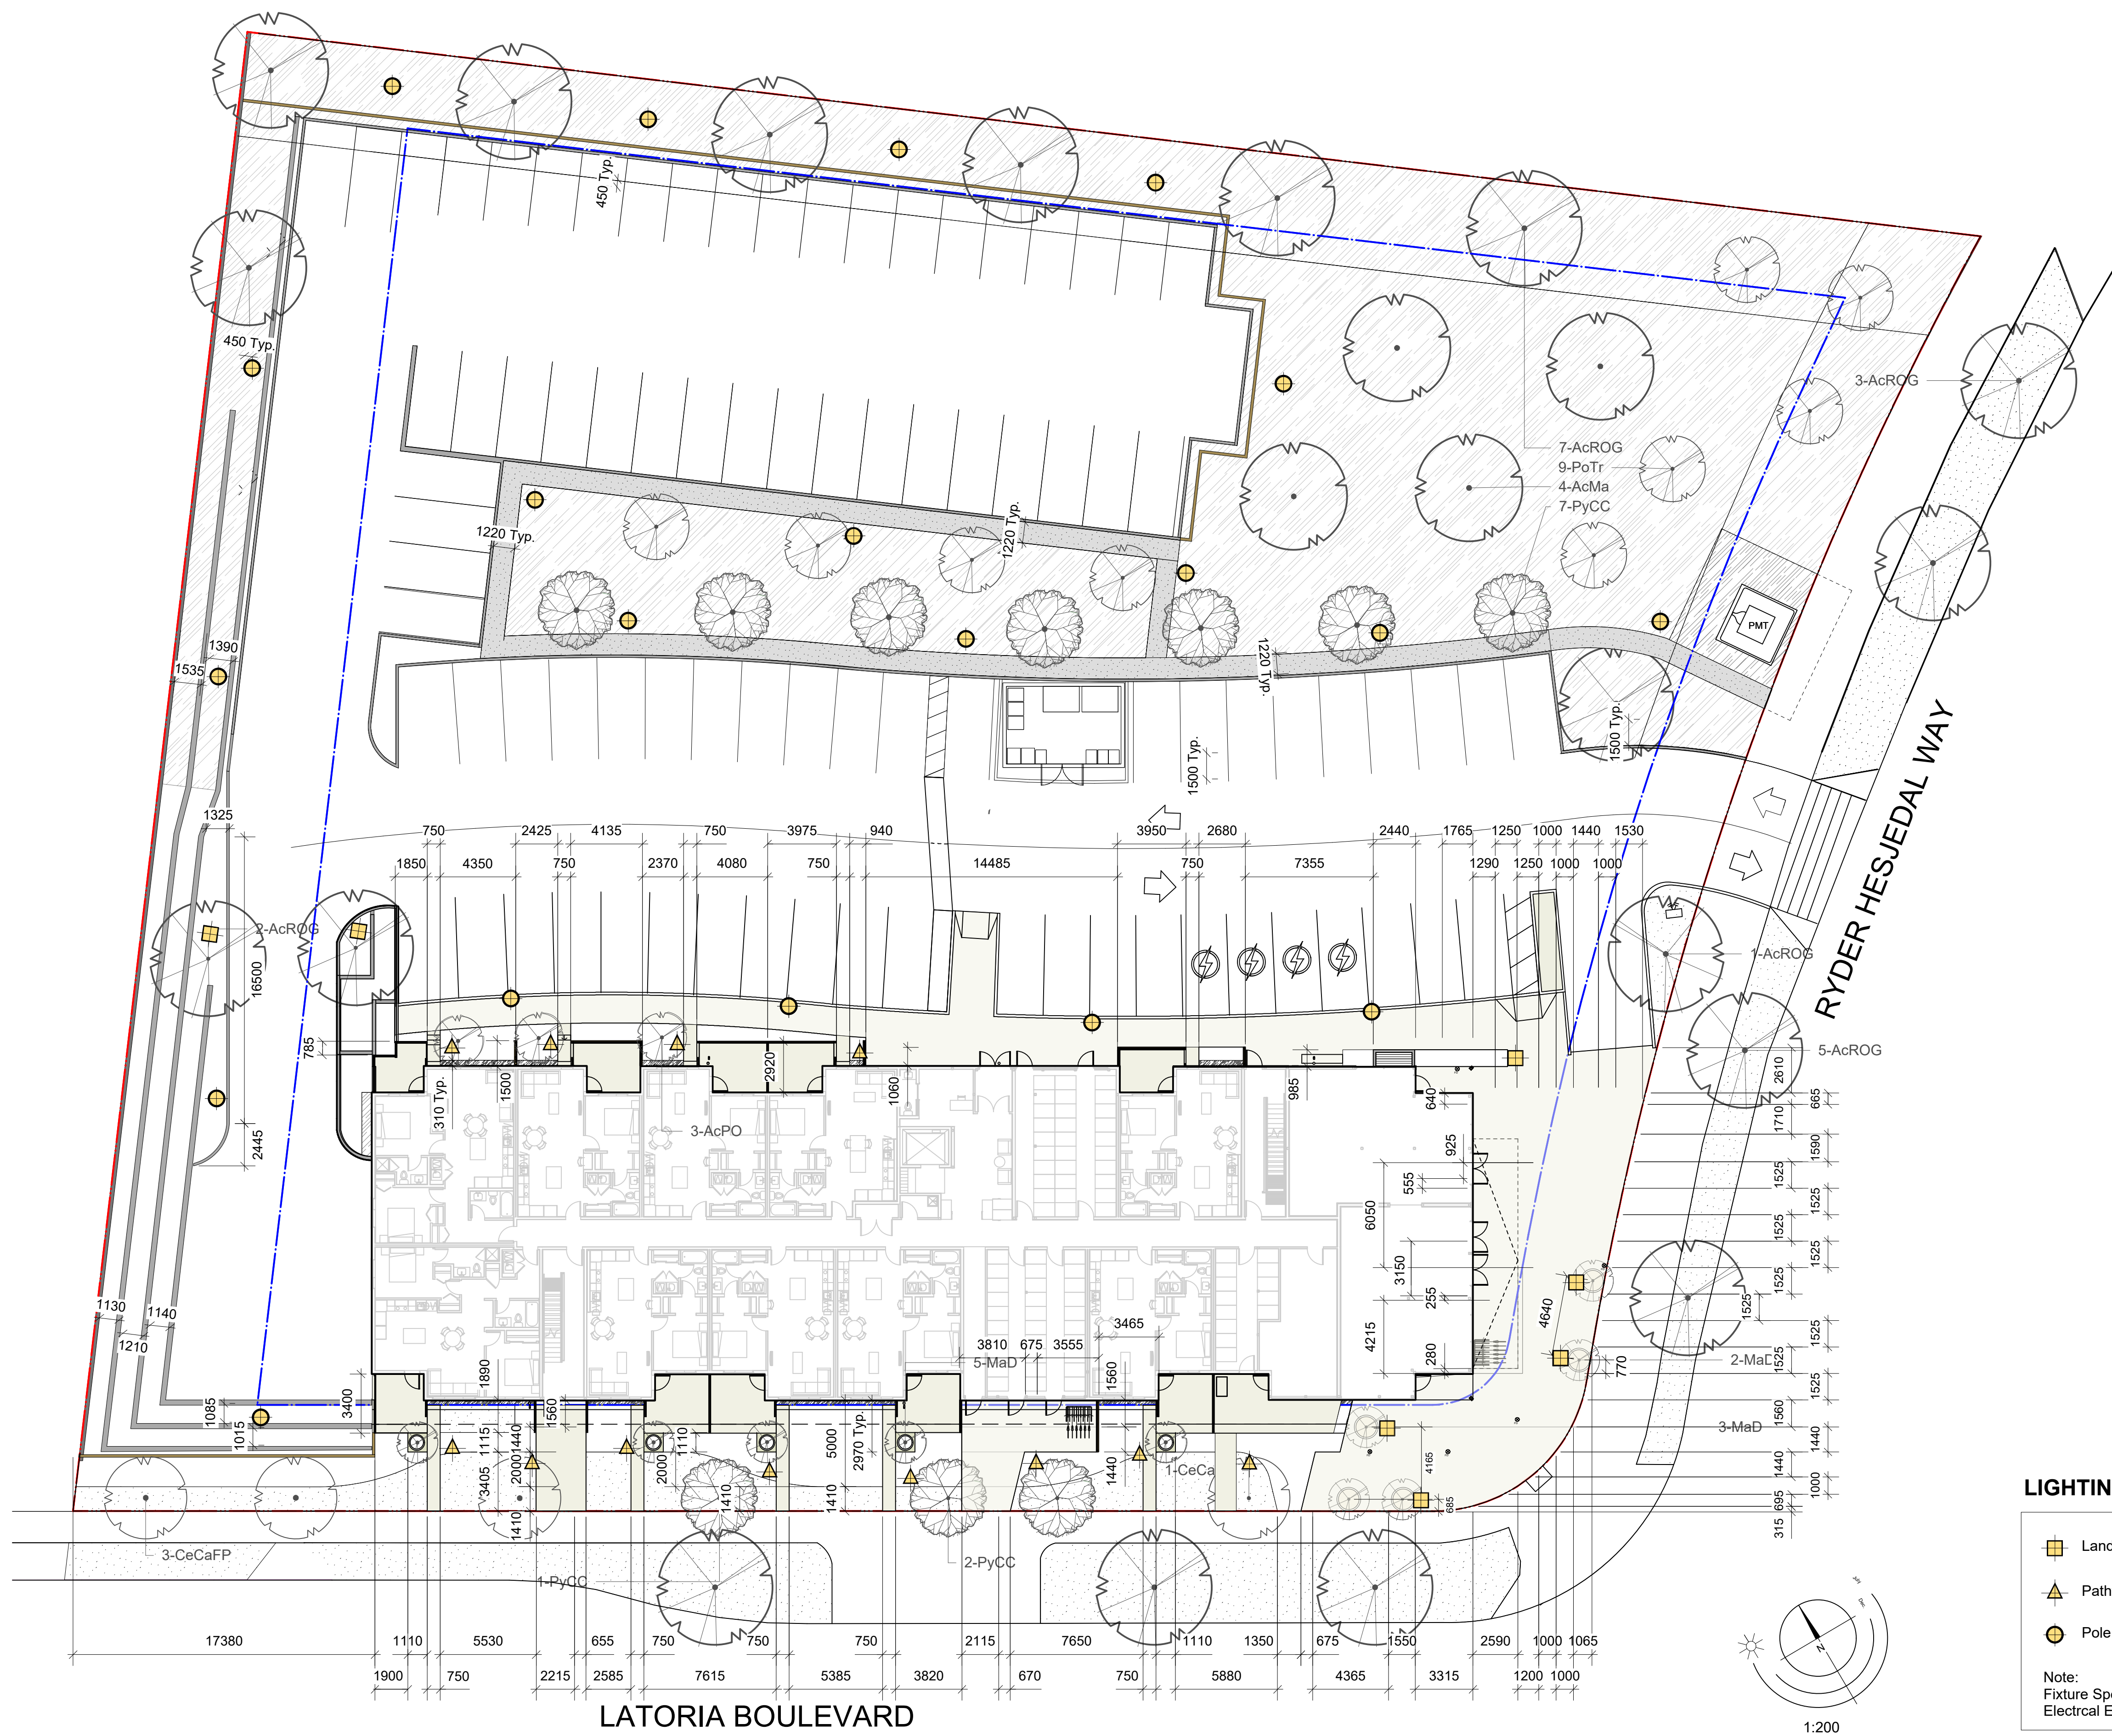

LIGHTING LEGEND


- Landscape Feature Lighting | Total: 7
- Pathway Light | Total: 12
- Pole Light (Lamp Standard) | Total: 20

Note:
Fixture Specifications TBD, to be coordinated with Electrical Engineer

1 Layout and Lighting plan
L3 1:200

NO.	DATE	DESCRIPTION
7	Oct 05-23	As-Built
6	Dec 21-22	Re-issued for Construction
5	Oct 05-22	Issued for Site Instruction No. 2
4	Sep 16-22	Re-issued for Construction
3	Apr 13-21	PMT Notes Added
2	Jan 18-21	Issued for Construction
1	Sept 29-20	Issued for FT

REVISIONS




#3-864 Queens Ave. Victoria B.C. V8T 1M5
Phone: (250) 598-0105

PROJECT
3554 Ryder Hesjedal Way
Royal Bay
Colwood, BC

TITLE
Landscape Layout & Lighting Plan

SCALE: 1:200
DRAWN: CW
CHECKED: BW
PROJECT No. 2003


DATE: Aug 24-20
SHEET: L3 of 4

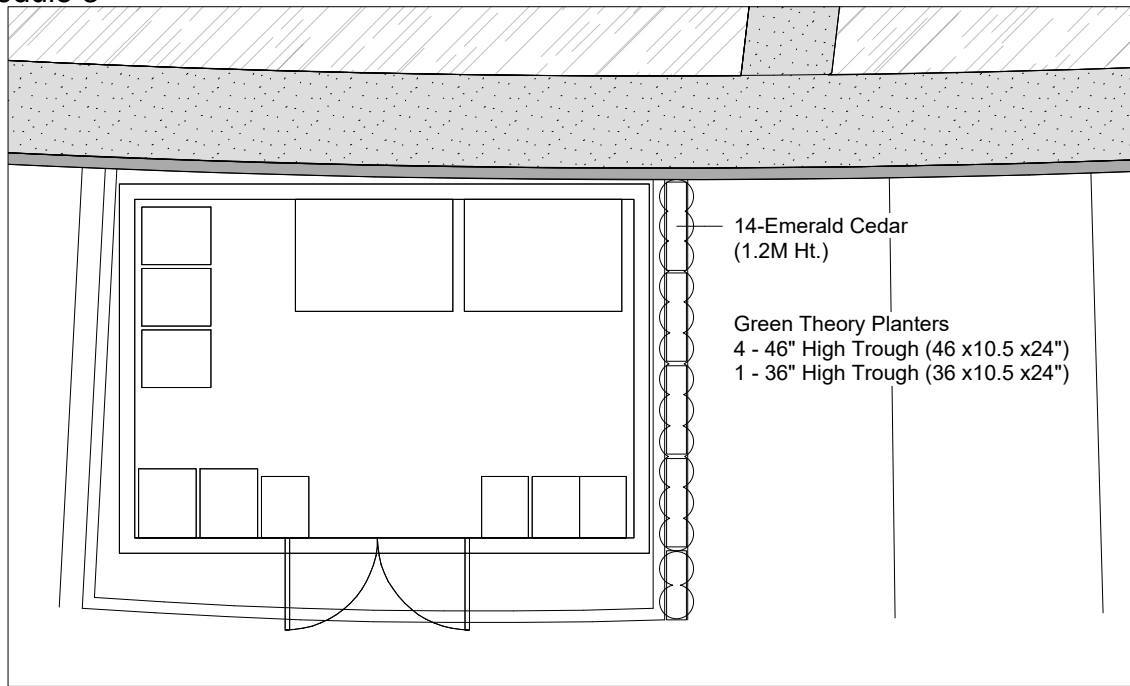

14-Emerald Cedar
(1.2M Ht.)

Green Theory Planters
4 - 46" High Trough (46 x10.5 x24")
1 - 36" High Trough (36 x10.5 x24")

1 Garbage Enclosure - Freestanding Planters
1:100

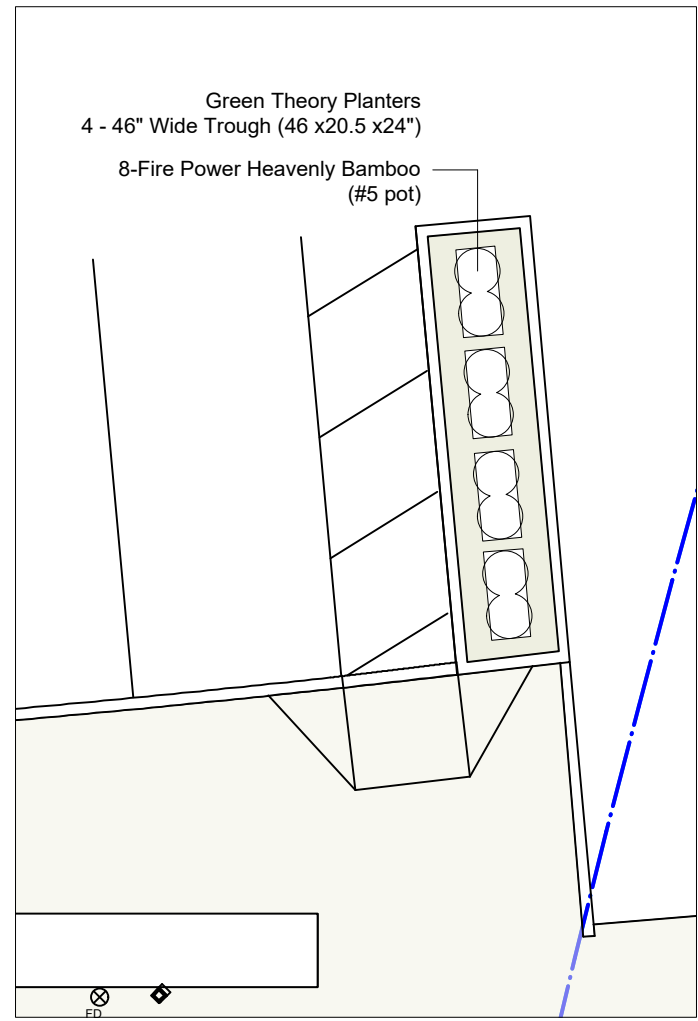

Green Theory Planters
4 - 46" Wide Trough (46 x20.5 x24")

8-Fire Power Heavenly Bamboo
(#5 pot)

2 Loading Area - Freestanding Planters
1:100

GENERAL NOTES

1. All freestanding aluminum planters to be supplied by Green Theory. Planters to be sized as noted.
2. Planter finish and color to be powdercoated 'Rust' (Standard Color).
3. Drip trays not required

PROJECT: 3554 Ryder Hesjedal Way

DRAWING TITLE: Post Construction - Additional Freestanding Planters


DRAWING #: SK-L04

DATE: December 1, 2023




LADR LANDSCAPE ARCHITECTS

#3-864 Queens Ave. Victoria B.C. V8T 1M5
Phone: (250) 598-0105

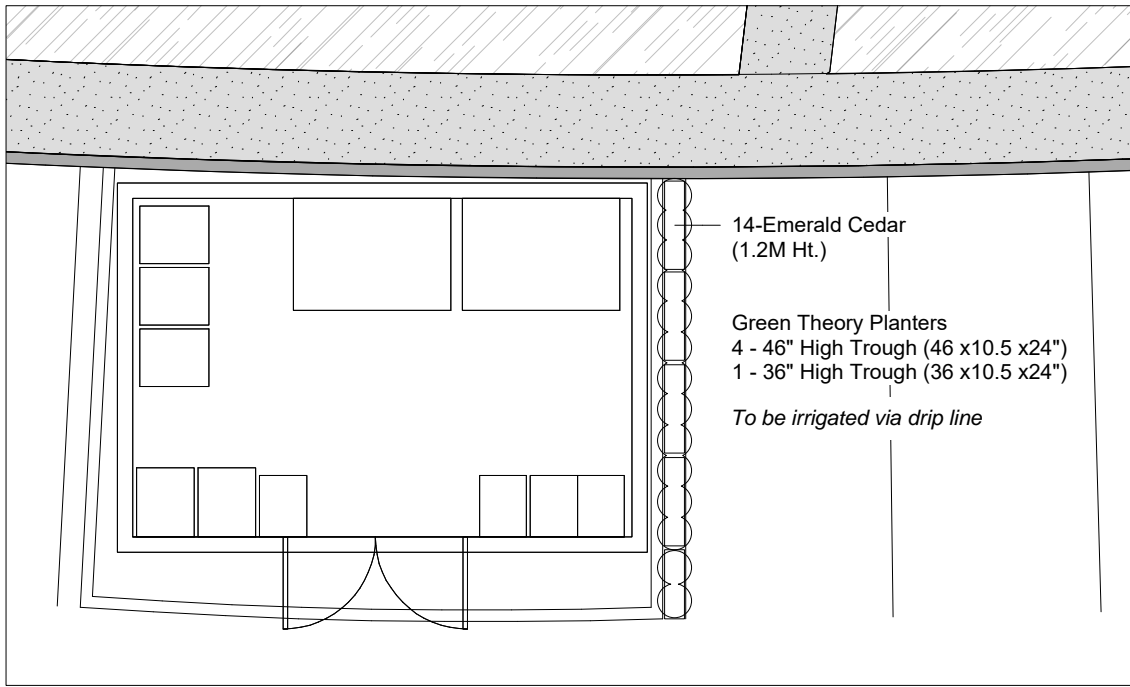

1 Garbage Enclosure - Freestanding Planters
1:100

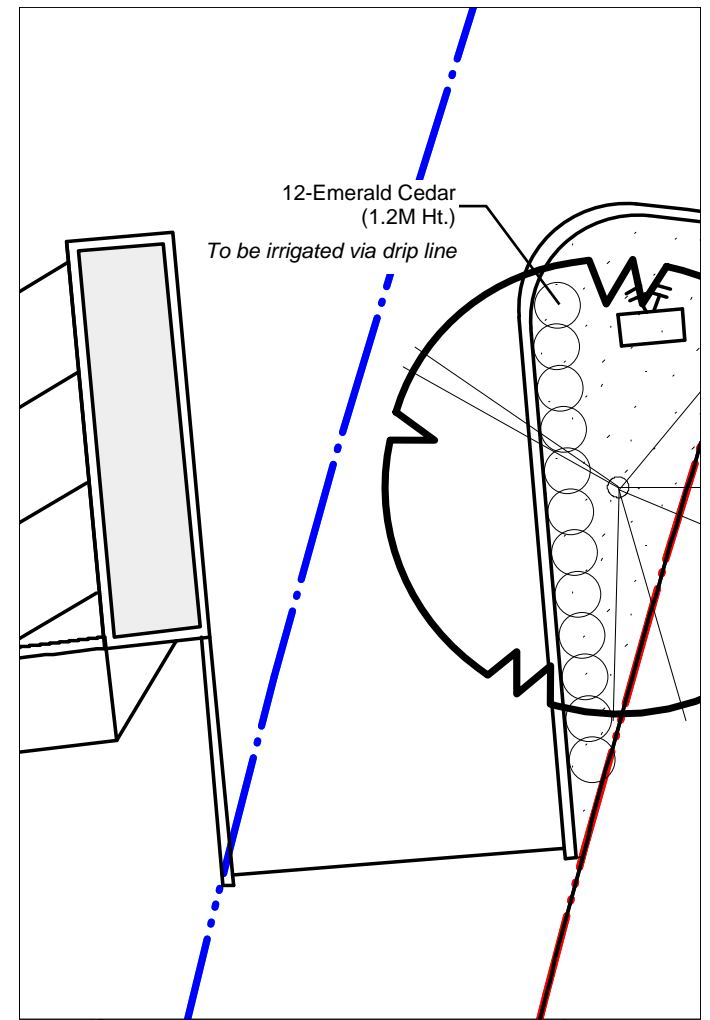

2 Loading Bay - Hedge Planting
1:100

GENERAL NOTES

1. All freestanding aluminum planters to be supplied by Green Theory. Planters to be sized as noted.
2. Planter finish and color to be powdercoated 'Rust' (Standard Color).
3. Drip trays not required

PROJECT: 3554 Ryder Hesjedal Way

DRAWING TITLE: Post Construction - Additional Freestanding Planters

DRAWING #: SK-L04

DATE: December 11, 2023



LADR LANDSCAPE ARCHITECTS

#3-864 Queens Ave. Victoria B.C. V8T 1M5
Phone: (250) 598-0105